

8037.ZK.1251A,B,C & D
AIR COMPRESSOR

MOTOR : -
CAPACITY : -
MANUFACTURER : ATLAS COPCO

8037.V.1251B&C
AIR RECEIVER VESSEL

DIMENSION : 39 9/16" ODx48 1/2" T/T
VOLUME : 41.2 FT³
DESIGN : 160 PSIG : 100°F


8037.F.1251A,B,C& D
FILTERS

DESIGN : -
CAPACITY : -
MANUFACTURER : ATLAS COPCO

8037.D.1251B
AIR DRYER

MOTOR : -
CAPACITY : -
MANUFACTURER : ATLAS COPCO

NOTE 1

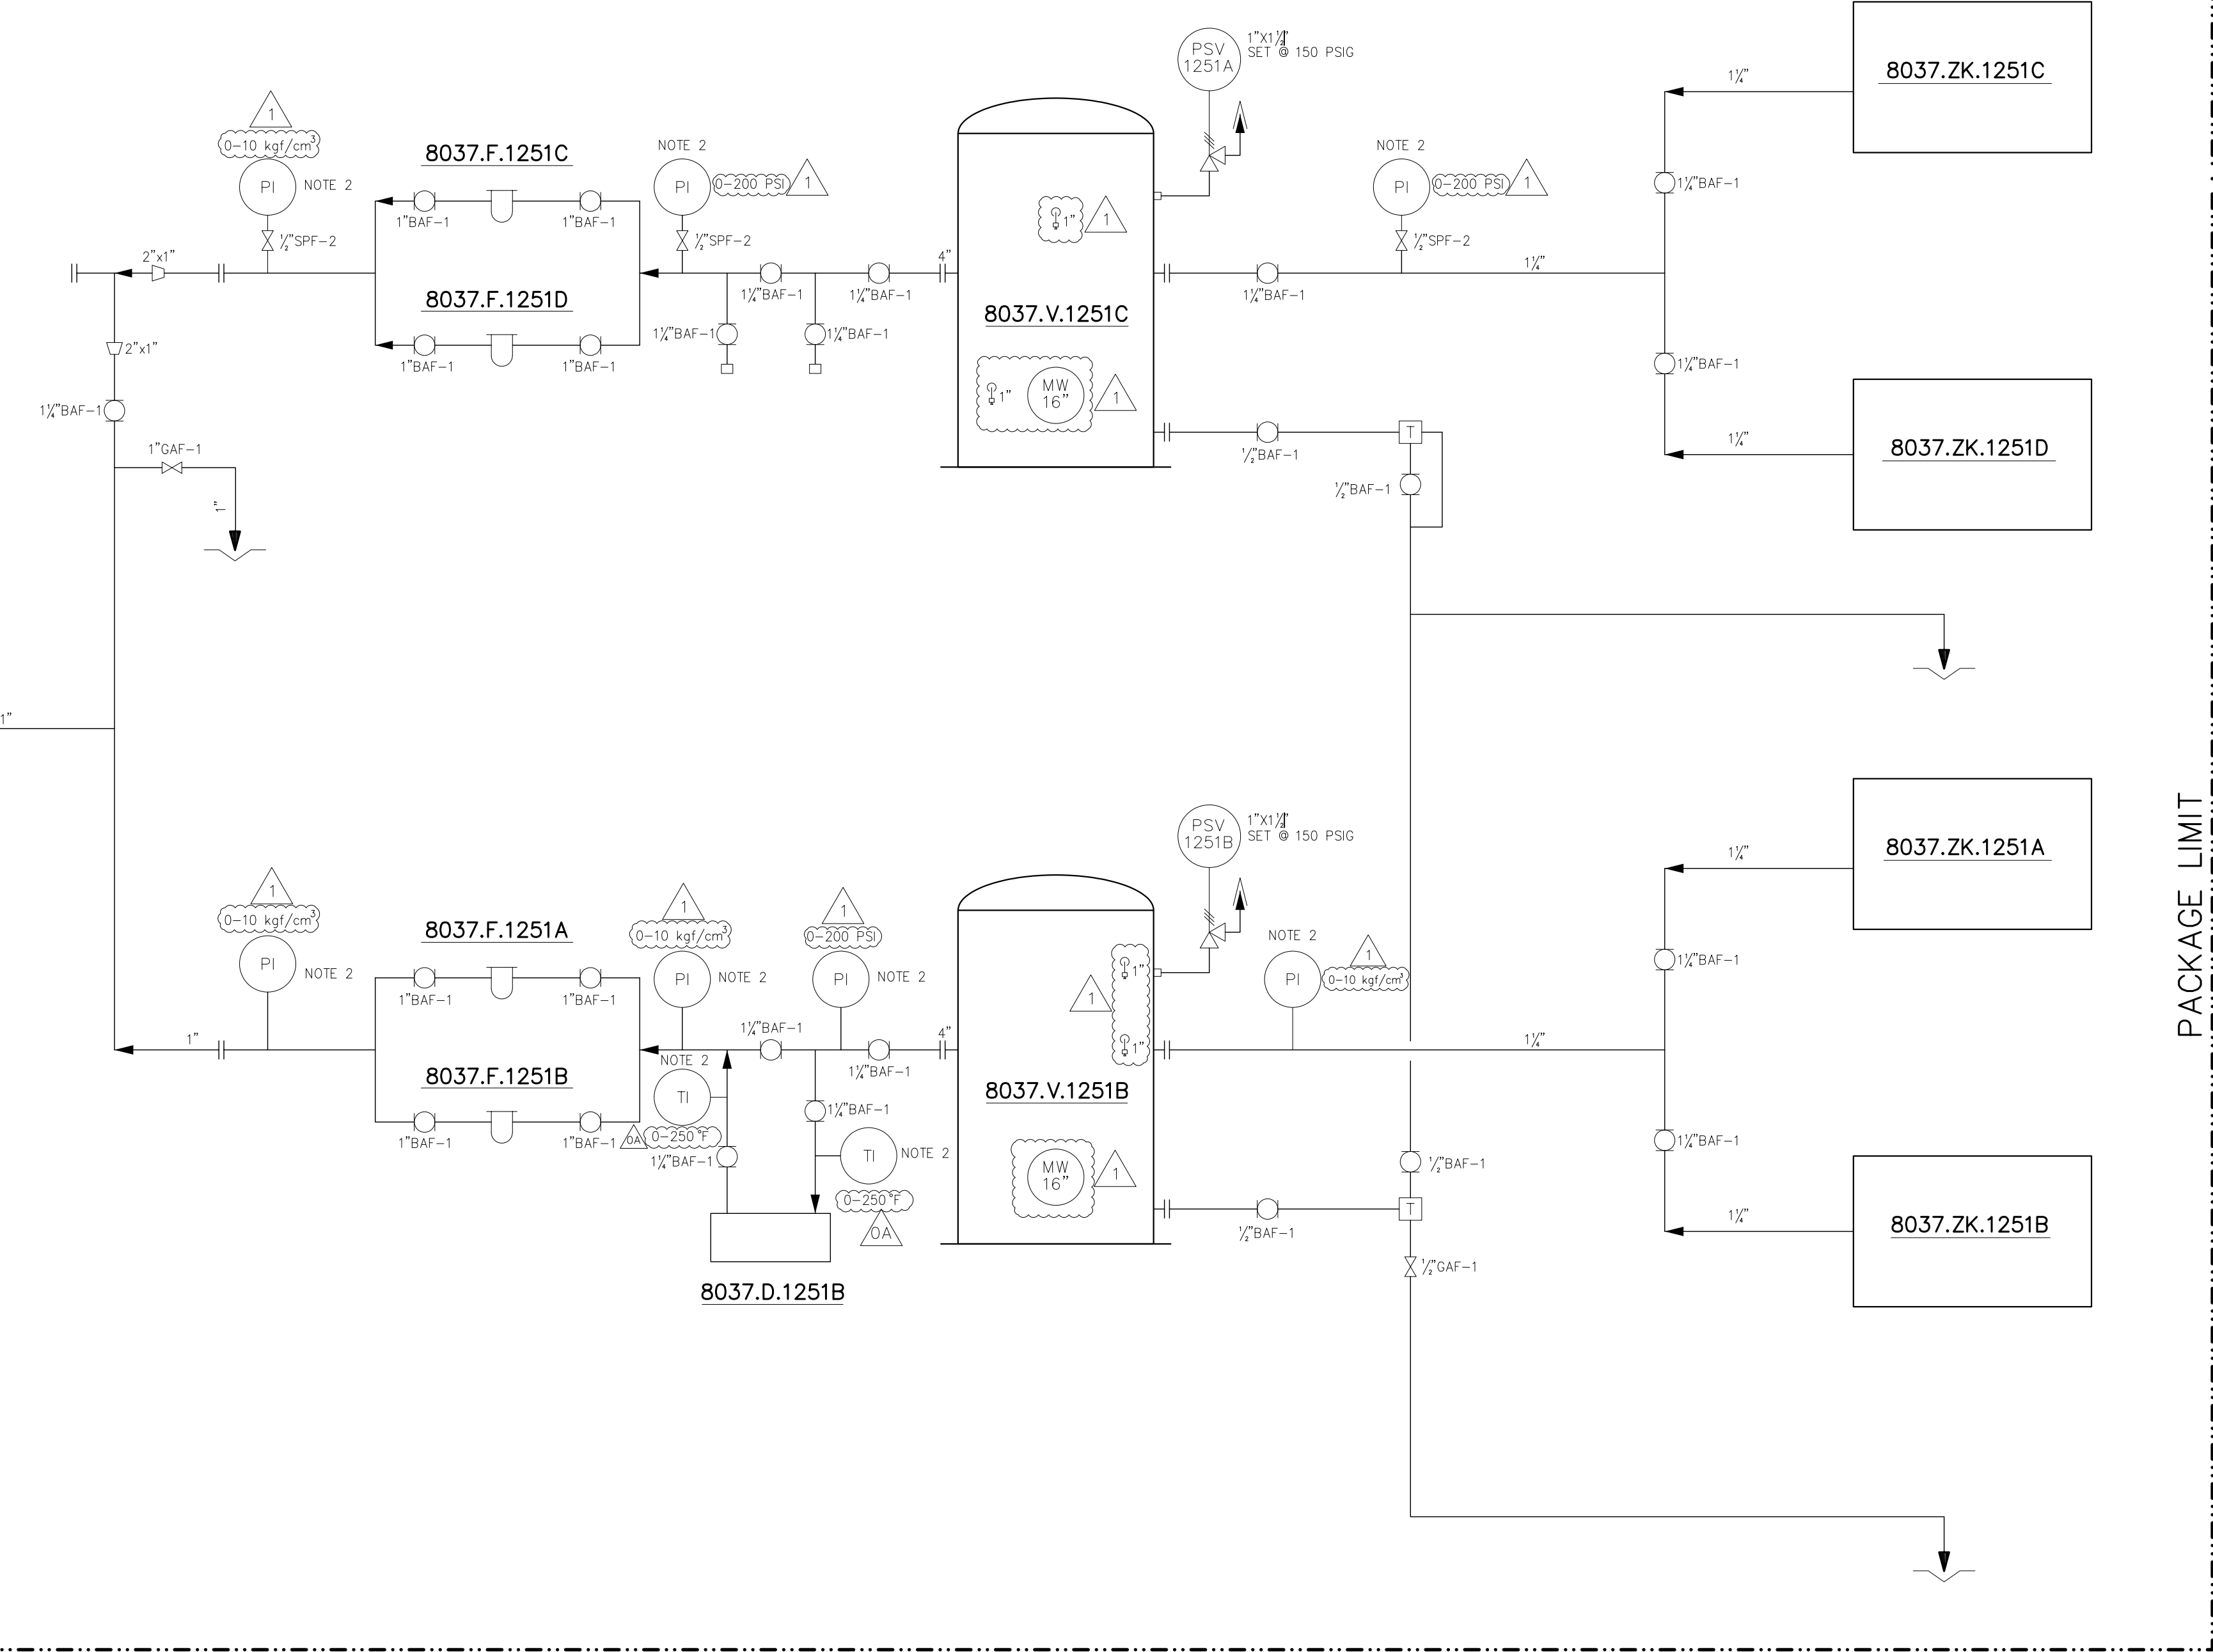

NOTES

1. INSTRUMENT AIR FOR BACKUP
2. NAME TAG IS NOT INSTALLED AS PER ACTUAL CONDITION

REFERENCE DRAWING

CP-603GS-PP-190	PIPING ISOMETRIC PSV 1251A AIR COMPRESSOR PACKAGE 8037.ZK.1251 WTP FACILITY CGS-3 DURI HOOU
CP-603GS-PP-191	PIPING ISOMETRIC PSV 1251B AIR COMPRESSOR PACKAGE 8037.ZK.1251 WTP FACILITY CGS-3 DURI HOOU

REVISION	DESCRIPTION	DATE	BY	CHECKED	APPROVED	STATUS
1	AS BUILT AS PER PSI REVALIDATION MOC#481540	07-12-18	SM	AM	-	TZSX
0A	ISSUED FOR REVIEW (PSI V&V AS PER MOC #481540)	07-11-18	DNR	AM	-	TZSX
0	UP-DATE FOR SMO FLARE & RELIEF PROJECT (JOB NO.#2332)	31-03-16	ND	EVK	AJ	MWS
REV	DESCRIPTION	DRAWN	CH'K	LEAD ENG	PROJ MNGR	OPR'G APP'D



SCALE : NTS DATE : 14-09-15
DRAWN : ND CH'K : EVK LEAD ENG : - PROJ MNGR : AJ
OPR'G APPROVAL : MWS
ENG APPROVAL : MRD

PIPING AND INSTRUMENT DIAGRAM
INSTRUMENT AIR SYSTEM
AIR COMPRESSOR PACKAGE 8037.ZK.1251 WTP FACILITY
CENTRAL GATHERING STATION-3
DURI HOOU

NEW DRAWING NO. DURI-WTPF03GS000-PRO-PID-IBU-0047-00	SIF No. 2332	LOCATION CGS-3	DRAWING No. CP-603GS-EF-087	REV. 1
---	-----------------	-------------------	--------------------------------	-----------

CP-603GS-PP-087

A3