


8037.P.1204 G.H.K.L.M
FLOTATION FEED PUMPS
DUTY : 2500 GPM PER PUMP
FLANGE RATING : 150 #
PUMP LENGTH : 1
ELECTRICAL : 3 PH / 60 CY/ 460 V

8037.W.1202E
FLOTATION UNIT FEED PIT
NOTE 7

8037.P.1503A&B
SURGE TANK MAKE UP WATER FEED PUMPS
CAPACITY : 800 GPM
HEAD : 106 FT
POWER : 50 HP

8037.P.0804E
RECOVERED OIL PUMP
CPI CONFIRM

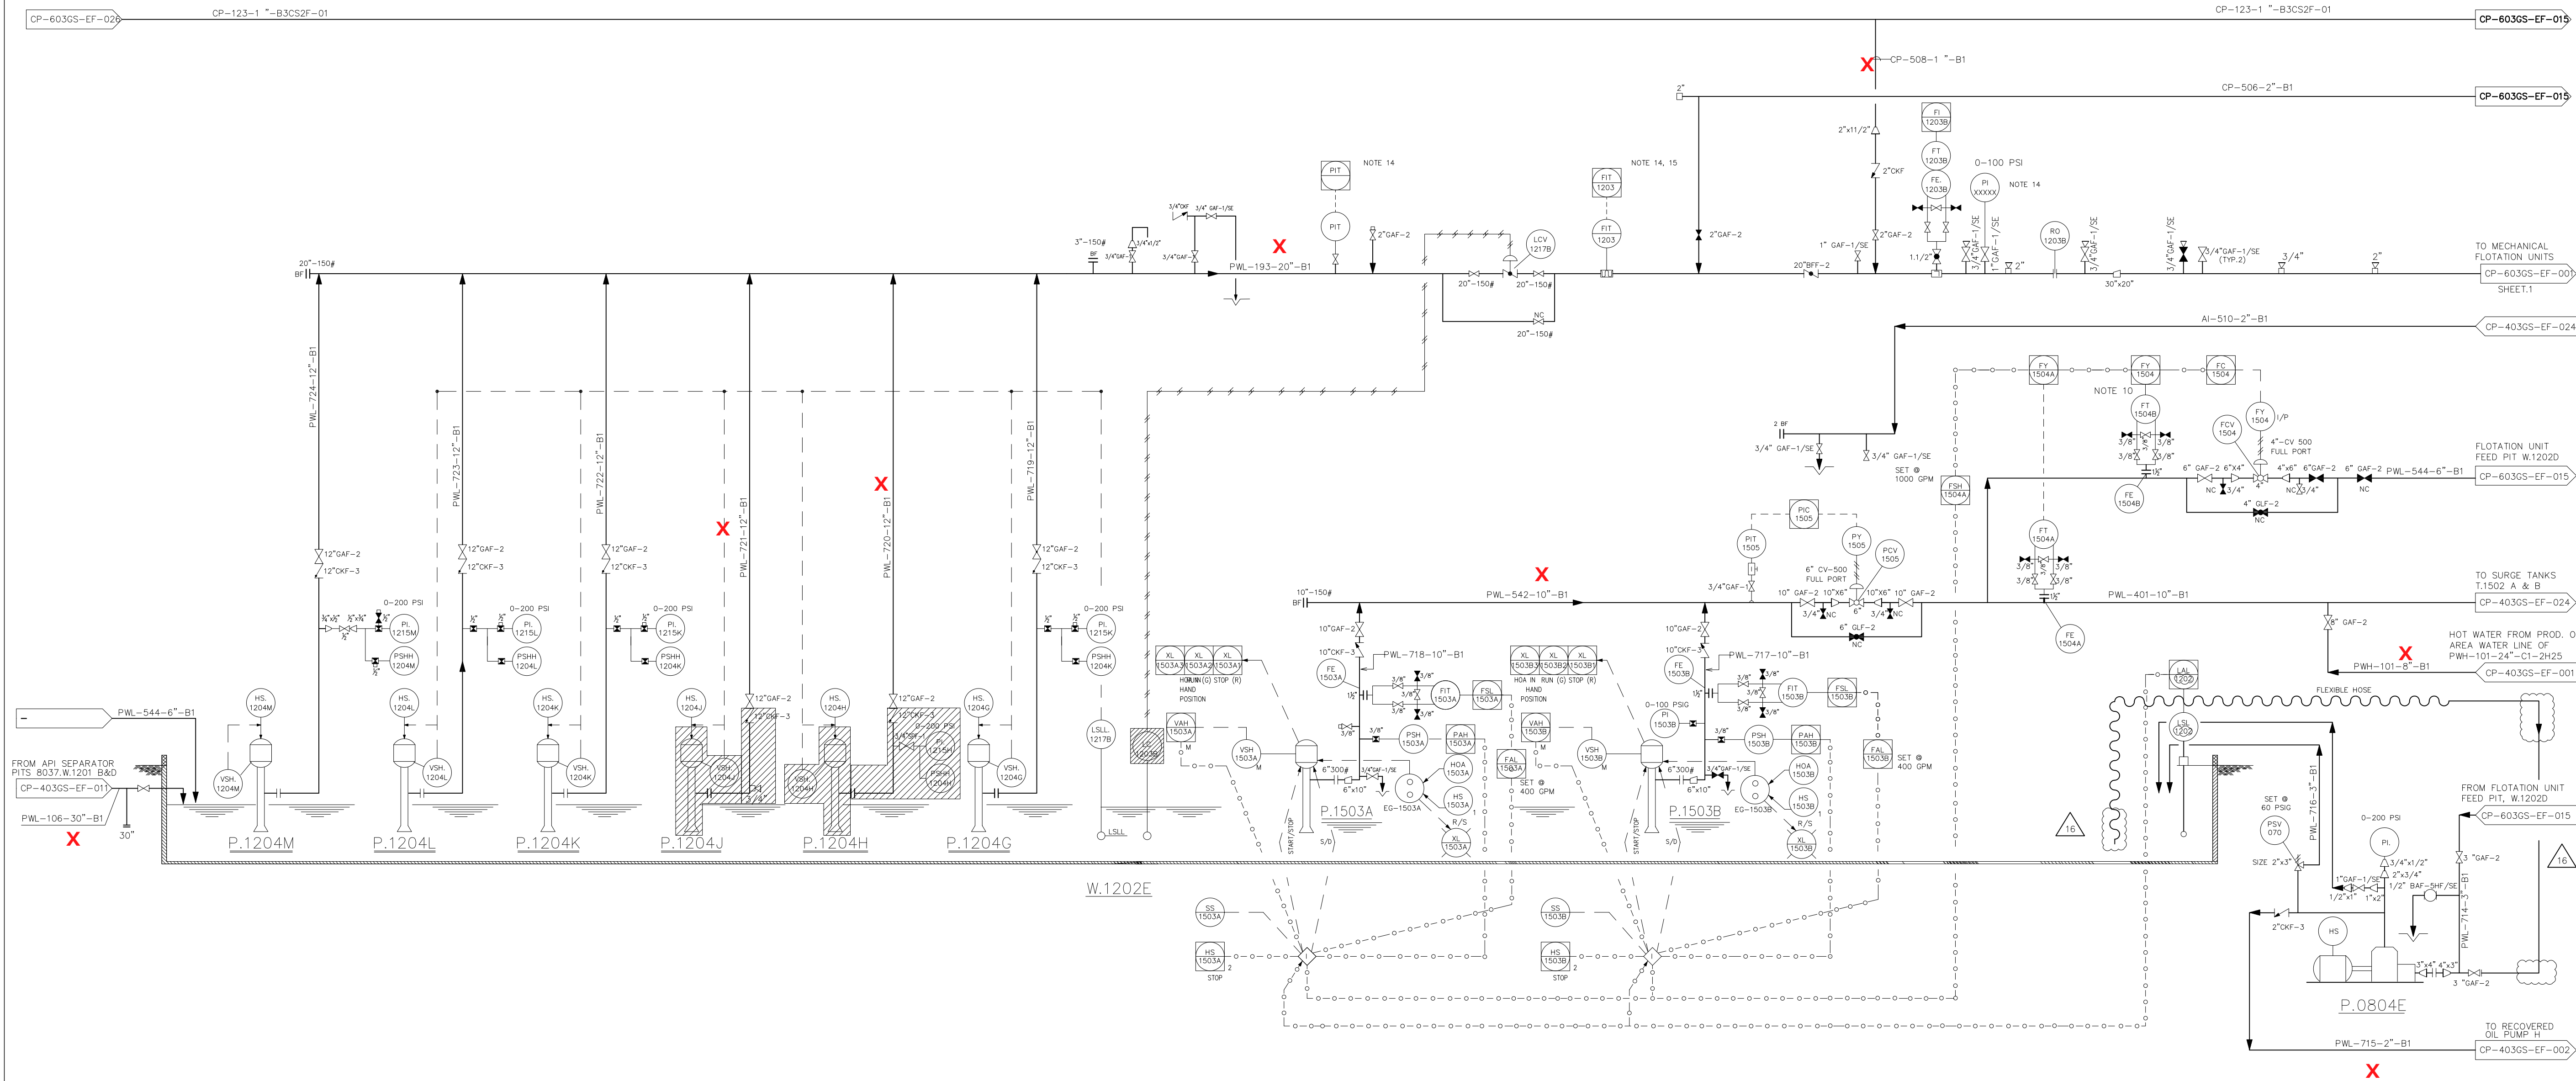

NOTES:

- ALL EQUIPMENT AND INSTRUMENTS ON THIS DRAWING HAVE THE PREFIX 8037. ALL LINE AND DRAWING NUMBERS ON THIS DRAWING HAVE THE PREFIX 40305 UNLESS OTHERWISE NOTED.
- THE LETTERS "Y" & "Q" ARE NOT USED IN THE EQUIPMENT NUMBERING SYSTEM.
- FOR STANDARD P & ID LEGEND SEE THE FOLLOWING DRAWINGS:
FOR PIPING & EQUIPMENT DWG. NO. CP-0500N-EF-002
FOR INSTRUMENTATION DWG. NO. CP-0500N-EF-002
- DELETED
- DELETED
- DELETED
- SEE DRAWING NO. CP-603GS-EF-015 FOR REFERENCE.
- ALL HIGH AND LOW POINTS IN PIPING TO HAVE "F" CONNECTION WITH GATE VALVE AND HEX. PLUG FOR VENTS AND DRAINS.
- ANY TYPICAL DRAWING WILL USE DRAWING NUMBER OF CGS-4 AS REFERENCE
- FLOW FROM FE 1504B = PUMP MINIMUM FLOW - FLOW FROM FE 1504A
IF NEGATIVE NUMBER IS CALCULATED, FLOW THROUGH FE 1504B SHALL BE ZERO
- DELETED
- REFER TO DOCUMENT CP-404GS-PP-102 FOR VALVE SIZE & TAG NUMBER

- INACTIVE
- TAG NUMBER IS NOT INSTALLED AS PER ACTUAL CONDITION
- FLOW TRANSMITTER ULTRASONIC TYPE

REV.	DATE	DESCRIPTION	BY	CHK.	ENG.	APPRO.	COORD.	REFERENCE DRAWINGS
16	02-10-19	UPDATE AS PER PSI V&V MOC#307724	RPN	PUTM	-	-	AOZL	P & ID WATER TREATMENT PLANT CP-603GS-EF-015
15	05-03-19	UPDATE AS PER PSI V&V MOC#307724	RPN	PUTM	-	-	AOZL	P & ID SURGE TANK & MAKE UP WATER PUMP CP-404GS-EF-020
14	15-02-19	UPDATE AS PER PSI V&V MOC#307724	RPN	PUTM	-	-	AOZL	
13	21-12-18	AS BUILT (PSI V&V) MOC#481540	RPI	AM	-	-	TZSX	
12	16-12-15	AS BUILT PSM-PP REMEDIATION PROJECT UNDER JOB NO.2445	APR	JX	BAY	MWS	BAY	
11	22/07/15	UPDATE FOR SMO FLARE & RELIEF PROJECT (JOB NO.2332)	RDY	EVK	MWD	MWS		
10	03/11/11	AS BUILT DONE BY TF JAKARTA	ARN	DKM	HKS	JA	AKH	



DRAWN : RUL
CHECKED : ADR
ENG'R. : DAW
APP'D :
COMPANY :

DRAWING TITLE
PIPING & INSTRUMENT DIAGRAM
SURGE TANK MAKE UP WATER FEED
PUMPS AND FLOTATION FEED PUMPS
CENTRAL GATHERING STATION
DURI AREA-3

ITC NO.
21/0E-PMF/RP/2011
21/0E-PMF/2011
SCALE: N.T.S.
SIZE:
DRAWING NO.

CAD
DRAWN WITH CAD
NEVER CHANGE THIS
DRAWING BY HAND

CP-403GS-EF-025-16