


8037.P.1213A & B
WATER DISPOSAL TRANSFER PUMPS TO CIP
 DUTY : 3600 GPM / 200 PSIG / 1800 RPM
 SUCTION CONN. : 14" RF.-300#
 DISCHARGE CONN. : 8" RF.-300#
 MOTOR : 700 HP / 1800 RPM
 3 PH / 60 CY / 4160 V



| | | | | | | | | |
|--------------------|----------|--|-----|------|-------------|---------------|-----------|----------|
| 25 | 15-07-24 | AS BUILT MOC#457945 REMOVE INSULATION HOT WATER TANK COG-5 | RPN | PJMM | | | TXPA | |
| 25 | 05-05-24 | UPDATE AS PER PSI V&V (D #5590, 5592, 5605, 5606, 5607-5608, 5609, 5610, 5611) | RPN | PUTM | | | TXPA | |
| 24 | 19-12-19 | AS BUILT MOC#442619 CONDITION MONITORING FOR MAJOR PUMPS IN HEAVY OIL FACILITIES | MRO | HEN | | FJM | | |
| 23 | 03-10-19 | UPDATE AS PER PSI V&V MOC#307724 | RPN | PUTM | | | AOZL | |
| 22 | 17-09-19 | UPDATE AS PER PSI V&V MOC#307724 | RPN | PUTM | | | AOZL | |
| 21 | 17-05-19 | UPDATE AS PER PSI V&V MOC#307724 | RPN | PUTM | | | AOZL | |
| 20 | 09-01-19 | AS BUILT (PSI V&V AS PER MOC#481540) | SM | AM | | | TZSX | |
| REV. | DATE | DESCRIPTION | BY | CHKD | DESIGN ENGR | DESIGN T. LOR | PROJ ENGR | PSI COOR |
| REFERENCE DRAWINGS | | | | | | | | |

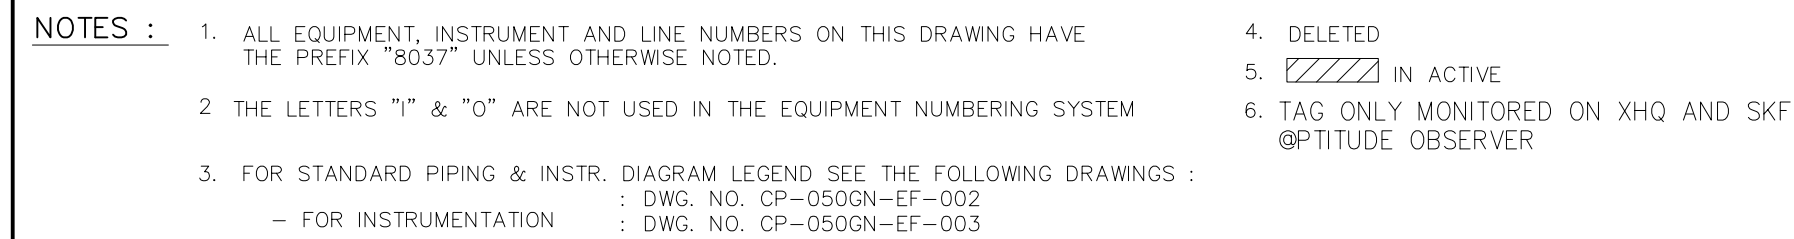

| | | | |
|--------------------|-----|--------------|---|
| DRAWN | AMN | 24 APRIL '91 | DRAWING TITLE PIPING AND INSTRUMENT DIAGRAM HOT WATER STORAGE TANK AND PUMPS WATER TREATING FACILITIES CENTRAL GATHERING STATION DURI AREA-3 |
| CHECKED | JAS | 7/10/92 | |
| DESIGN ENGR. | IWA | 7/10/92 | |
| DESIGN TEAM LEADER | | | |
| PROJECT ENGR. | BDG | 7/10/92 | |
| OPR'G DEPT. | | | |

| | |
|--|---|
| ITC NO. 21/OE-PMF/RP/2011 21/OE-PMF/2011 | CAD DRAWN WITH CAD NEVER CHANGE THIS DRAWING BY HAND |
| SCALE : N.T.S SIZE : | |
| DRAWING NO. CP-603GS-EF-012-26 | |
| DURI-WTPF03GS000-PRO-PID-IBU-0057-00 | |