

1 2 3 4 5 6 7 8 9 10 11 12 13 14 15 16

8037.ZK.1200 A & B
AIR COMPRESSOR

MOTOR : -
CAPACITY : 222 CFM
MANUFACTURER : SULLAIR
MODEL : 3709 e AC

8037.V.1200
AIR RECEIVER VESSEL

DIMENSION : -
VOLUME : -
DESIGN : -

8037.F.1200A & B
PRE FILTERS

DESIGN : -
CAPACITY : -
MANUFACTURER : HANKISON

8037.D.1200
AIR DRYER


TYPE : -
CAPACITY : -
PDP METER DISPLAY : -
MANUFACTURER : HANKISON

8037.F.1200 C & D
AFTER FILTERS

DESIGN : -
CAPACITY : -
MANUFACTURER : HANKISON

NOTES

1. MAIN INSTRUMENT AIR
2. NAME TAG IS NOT INSTALLED AS PER ACTUAL CONDITION

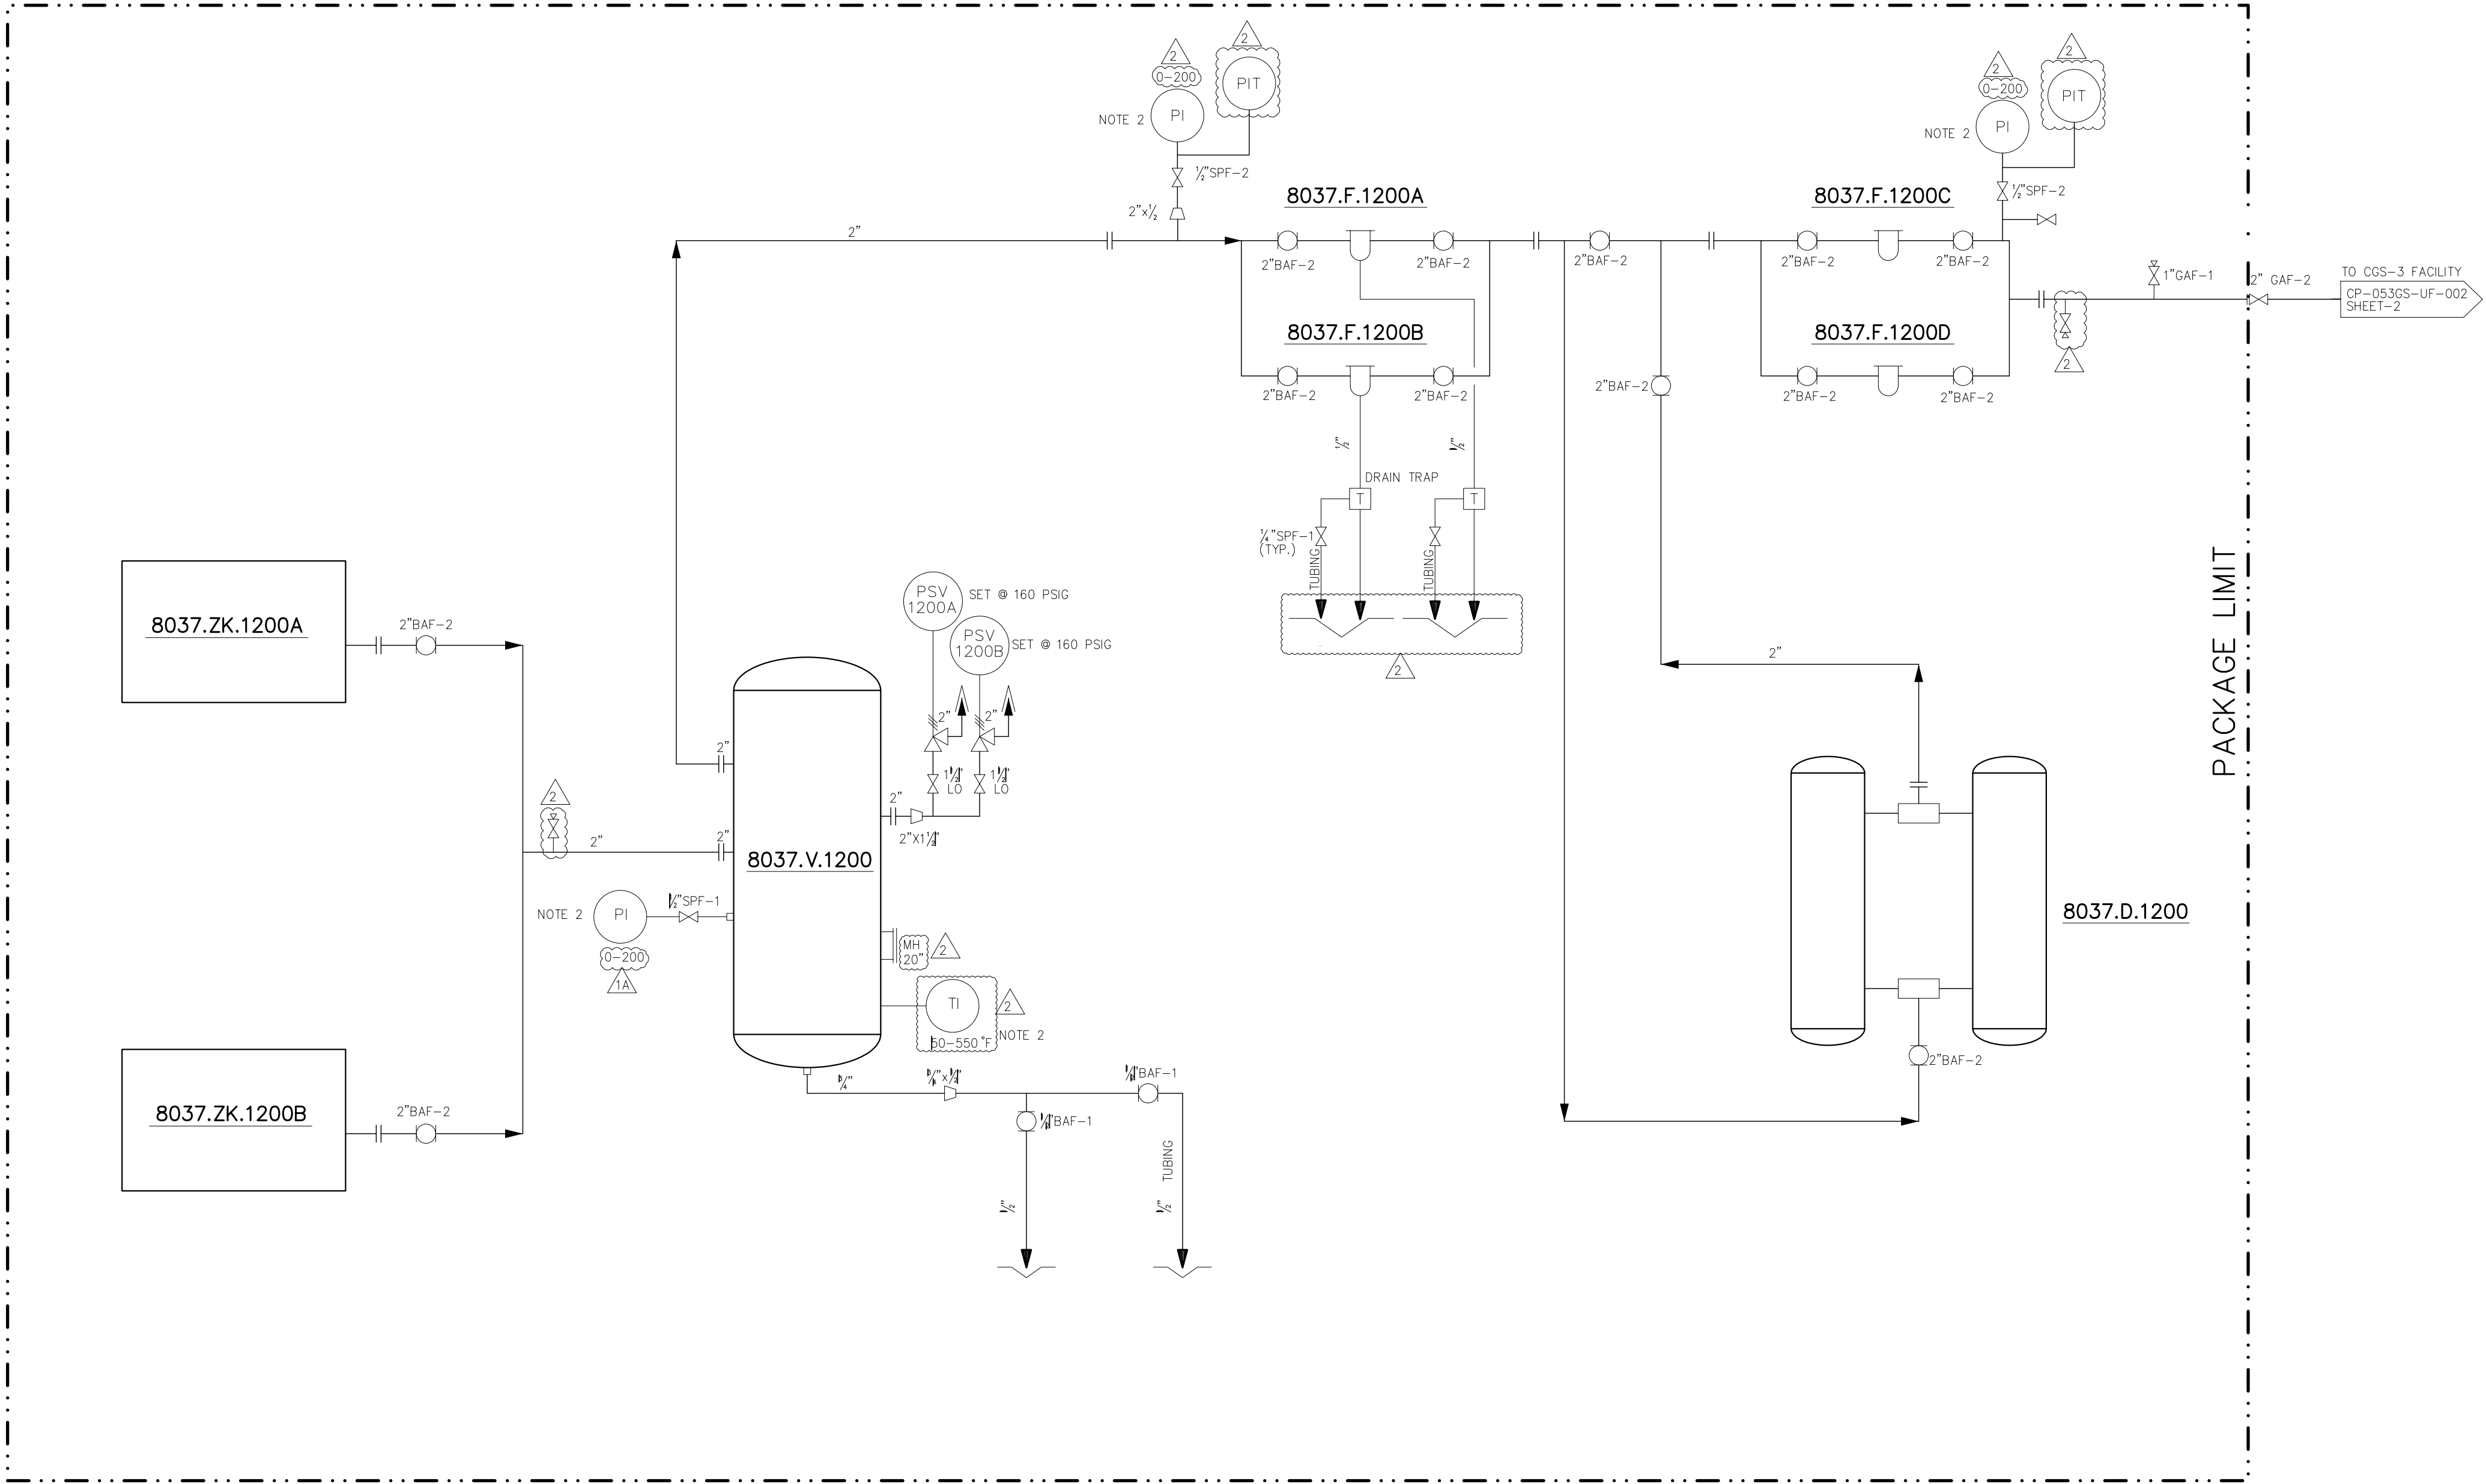

REFERENCE DRAWING

CP-603GS-PP-189 PIPING ISOMETRIC PSV V.1200A&B AIR RECEIVER VESSEL
AIR COMP.PACKAGE 8037.ZK.1200 WTP FACILITY CGS-3 DURI HOOU

REV	DESCRIPTION	DRAWN	CH'K	LEAD ENG	PROJ MNGR	OPR'G APP'D	ENG APP'D
2	AS BUILT AS PER PSI REVALIDATION MOC#481540	SM	AM	-	-	-	TZSX
1A	ISSUED FOR REVIEW (PSI V&V AS PER MOC #481540)	DNR	AM	-	-	-	TZSX
1	UPDATED AS PER FIELD VERIFICATION MOC#307724	ILH	TZSX	-	-	-	TZSX
0	UP-DATE FOR SMO FLARE & RELIEF PROJECT (JOB NO.#2332)	ND	EVK	-	AJ	MWS	MRD



SCALE : NTS DATE : 11-09-15
DRAWN : ND CH'K : EVK LEAD ENG : - PROJ MNGR : AJ
OPR'G APPROVAL : MWS
ENG APPROVAL : MRD

PIPING AND INSTRUMENT DIAGRAM
INSTRUMENT AIR SYSTEM
AIR COMPRESSOR PACKAGE 8037.ZK.1200 WTP FACILITY
CENTRAL GATHERING STATION-3
DURI HOOU

NEW DRAWING NO.	SIF No.	LOCATION	DRAWING No.	REV.
DURI-WTPF03GS000-PRO-PID-IBU-0046-00	2332	CGS-3	CP-603GS-EF-086	2

CP-603GS-PP-086

A3