

8037.P.0801A & B
OILY WATER RECYCLE PUMPS

DUTY : 16" PROVER LOOP, SMITH, 4,300 BPH
FLANGE : SUCTION, 3" - 300#
RATING : DISCHARGE, 1½"-300#

8037.T.0803A
SHIPPING TANK 7000 BBL

DIMENSION : 50'-0" DIA. x 20'-0" H
TRIM : TE-T-03A-B1
SEE NOTE 5

8037.P.0803A, D
HIGH PRESSURE SHIPPING PUMPS

TYPE : SCREW PUMP
CAPACITY : 210 GPM
DUTY : 250 HP/ 4160V / 60 HZ / 3PH / 1785 RPM

8037.P.0803B, C
HIGH PRESSURE SHIPPING PUMPS


DUTY : 925 GPM/930 FT/400 HP./3600 RPM
TRIM : TE-P-03-B1
FLANGE : SUCTION, 6"-300#
RATING : DISCHARGE, 4"-300#

8037.P.0803E
HIGH PRESSURE SHIPPING PUMP

DUTY : 900 GPM/930 FT/450 HP./3600 RPM
FLANGE : SUCTION, 6"-300#
RATING : DISCHARGE, 4"-300#

NOTE

- ALL EQUIPMENT, INSTRUMENT AND LINE NUMBER ON THIS DRAWING HAVE THE PREFIX "8037" UNLESS OTHERWISE NOTED.
- THE LETTERS 'I' & 'O' ARE NOT USED IN THE EQUIPMENT NUMBERING SYSTEM.
- DELETED
- SET PRESSURE VACUUM VENTS ON API TANK AT 0.5 OZ/IN VAC.
- API TANKS ON THIS DRAWING SHALL BE SPECIFIED FOR :
OPER : 0.3 OZ/IN PRESS. @ 135-200°F
DESIGN : 1.73 OZ/IN PRESS. 1.15 OZ/IN VAC. @ 200°F
- DELETED
- SHIPPING TANK LEVEL SWITCH SIGNAL (LSH) NOT STARTS CHARGE PUMPS OR HPS PUMP. BOTH AND HPS PUMP ARE STARTED MANUALLY
- INACTIVE
- DELETED
- PHR CONFIRM
- DELETED
- NAME TAG IS NOT INSTALLED IN ACTUAL CONDITION
- TANK OVERFLOW LIQUID DESIGN TYPE 2
- WILL SHUT -OFF P-0803 A/B/C/E/D
- WILL SHUT -OFF THE ASSOCIATED PUMP

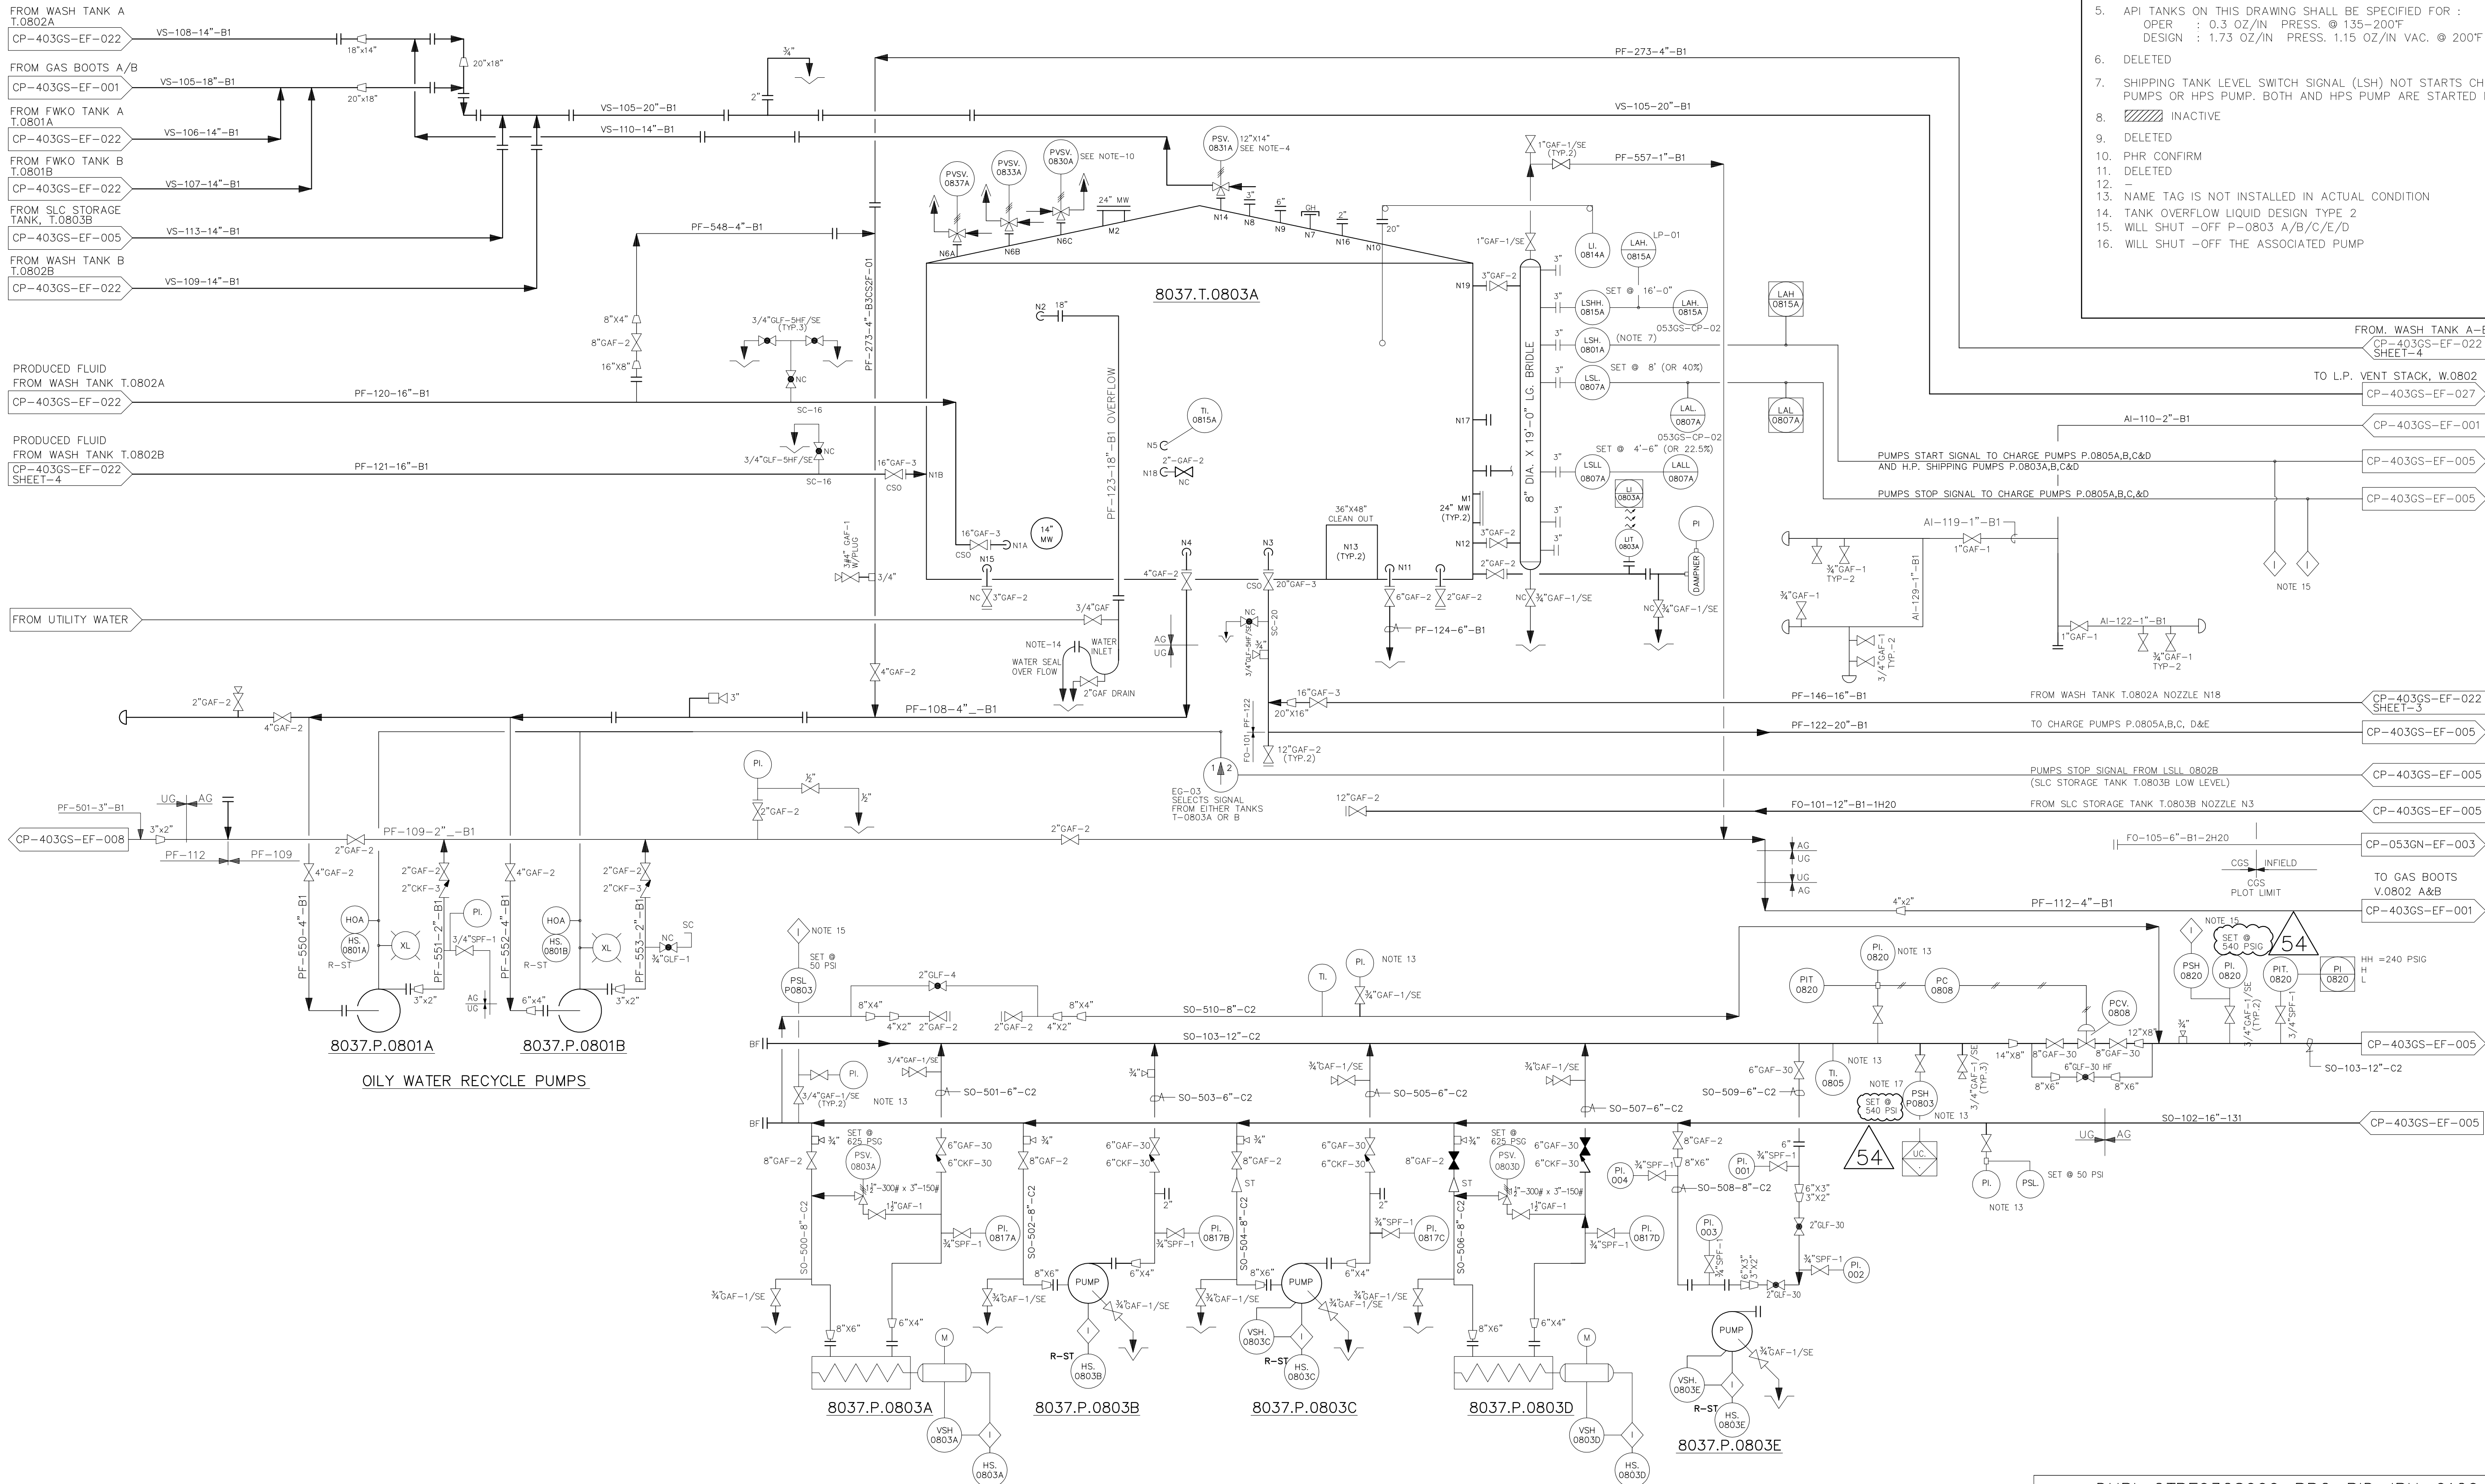

CP-GB-J15127(A~G&J)		PID STANDARD LEGENDS		54		18-MAR-25		KDF	RID	MAM	RIS	ASBUILT-WI-2025054324A1-MOC.48507-SWITCHING CGS-3 AND CGS-5 SHIPPING TO PERTAGAS SEGMENT 11A-11B INCLUDING DEOLUNGHCIT TRUNK LINE 24"-30"		<div><div></div><div>PERTAMINA</div><div>HULU ROKAN</div></div> <div>PIPING & INSTRUMENT DIAGRAM OIL TREATING FACILITIES SHIPPING TANK & HP SHIPPING PUMPS CENTRAL GATHERING STATION DURI AREA-3</div>															
CP-403GS-EF-001		P&ID OIL TREATING FACILITIES (SHT.-1)		53		14-01-25		APB	PWW	-	RIS	UPDATED AS PER PSI V&V (ID#8878 & 79) - REVISE AS PER ACTUAL CONDITION FOR NOTE-15 & LIT-0803A																	
CP-403GS-EF-005		P&ID OIL TREATING FACILITIES LACT UNIT		52		30-05-24		APB	PWW	-	RIS	UPDATED AS PER PSI V&V (ID#8650) - UPDATED PSH-P-0803																	
CP-603GS-EF-007		P&ID WATER TREATING FACILITIES SLOP TREATMENT		51		05-07-23		MRQ	SPW	MAM	RIS	SETTING INFORMATION AS PER ACTUAL CONDITION																	
CP-403GS-EF-006		P&ID OIL TREATING FACILITIES SLC STORAGE		50		29-05-23		RKP	PWW	-	RIS	ASBUILT HPS PUMP, WI-2022042344A1, MOC#14697																	
CP-403GS-EF-086		PIPING AND INSTRUMENT DIAGRAM INSTALLATION 4" CONTROL VALVE SHIPPING PUMPS 8037-FM-0803A,B,C,D,E		50		29-05-23		RKP	PWW	-	RIS	UPDATE AS PER PSI V&V (ID #8273)-DELETED SETTING ALARM FOR LIT-0803																	
DRAWING NO.		TITLE		NO		DATE		BY	DRAFT CHKD	ENGR CHKD	PSI COOR	PROJECT NO.		DRAWN:		ENGR:		DEPT:		DATE:		CP-403GS-EF-002							
		REFERENCE DRAWINGS										21/0E-PMF/RP/2011		FZ		TXPA		PSM		09-SEP-2020		SIZE: A1		SCALE: NTS		REV: 54		SHEET: 1 OF 1	