NOTE

1. ALL EQUIPMENT, INSTRUMENT AND LINE NUMBER ON THIS DRAWING HAVE THE PREFIX "8037" UNLESS OTHERWISE NOTED.
2. THE LETTERS 'I' & 'O' ARE NOT USED IN THE EQUIPMENT NUMBERING SYSTEM.
3. PUMP P.0804B RELOCATED TO CGS-10
4. PUMP P.0804D RELOCATED TO CGS-4

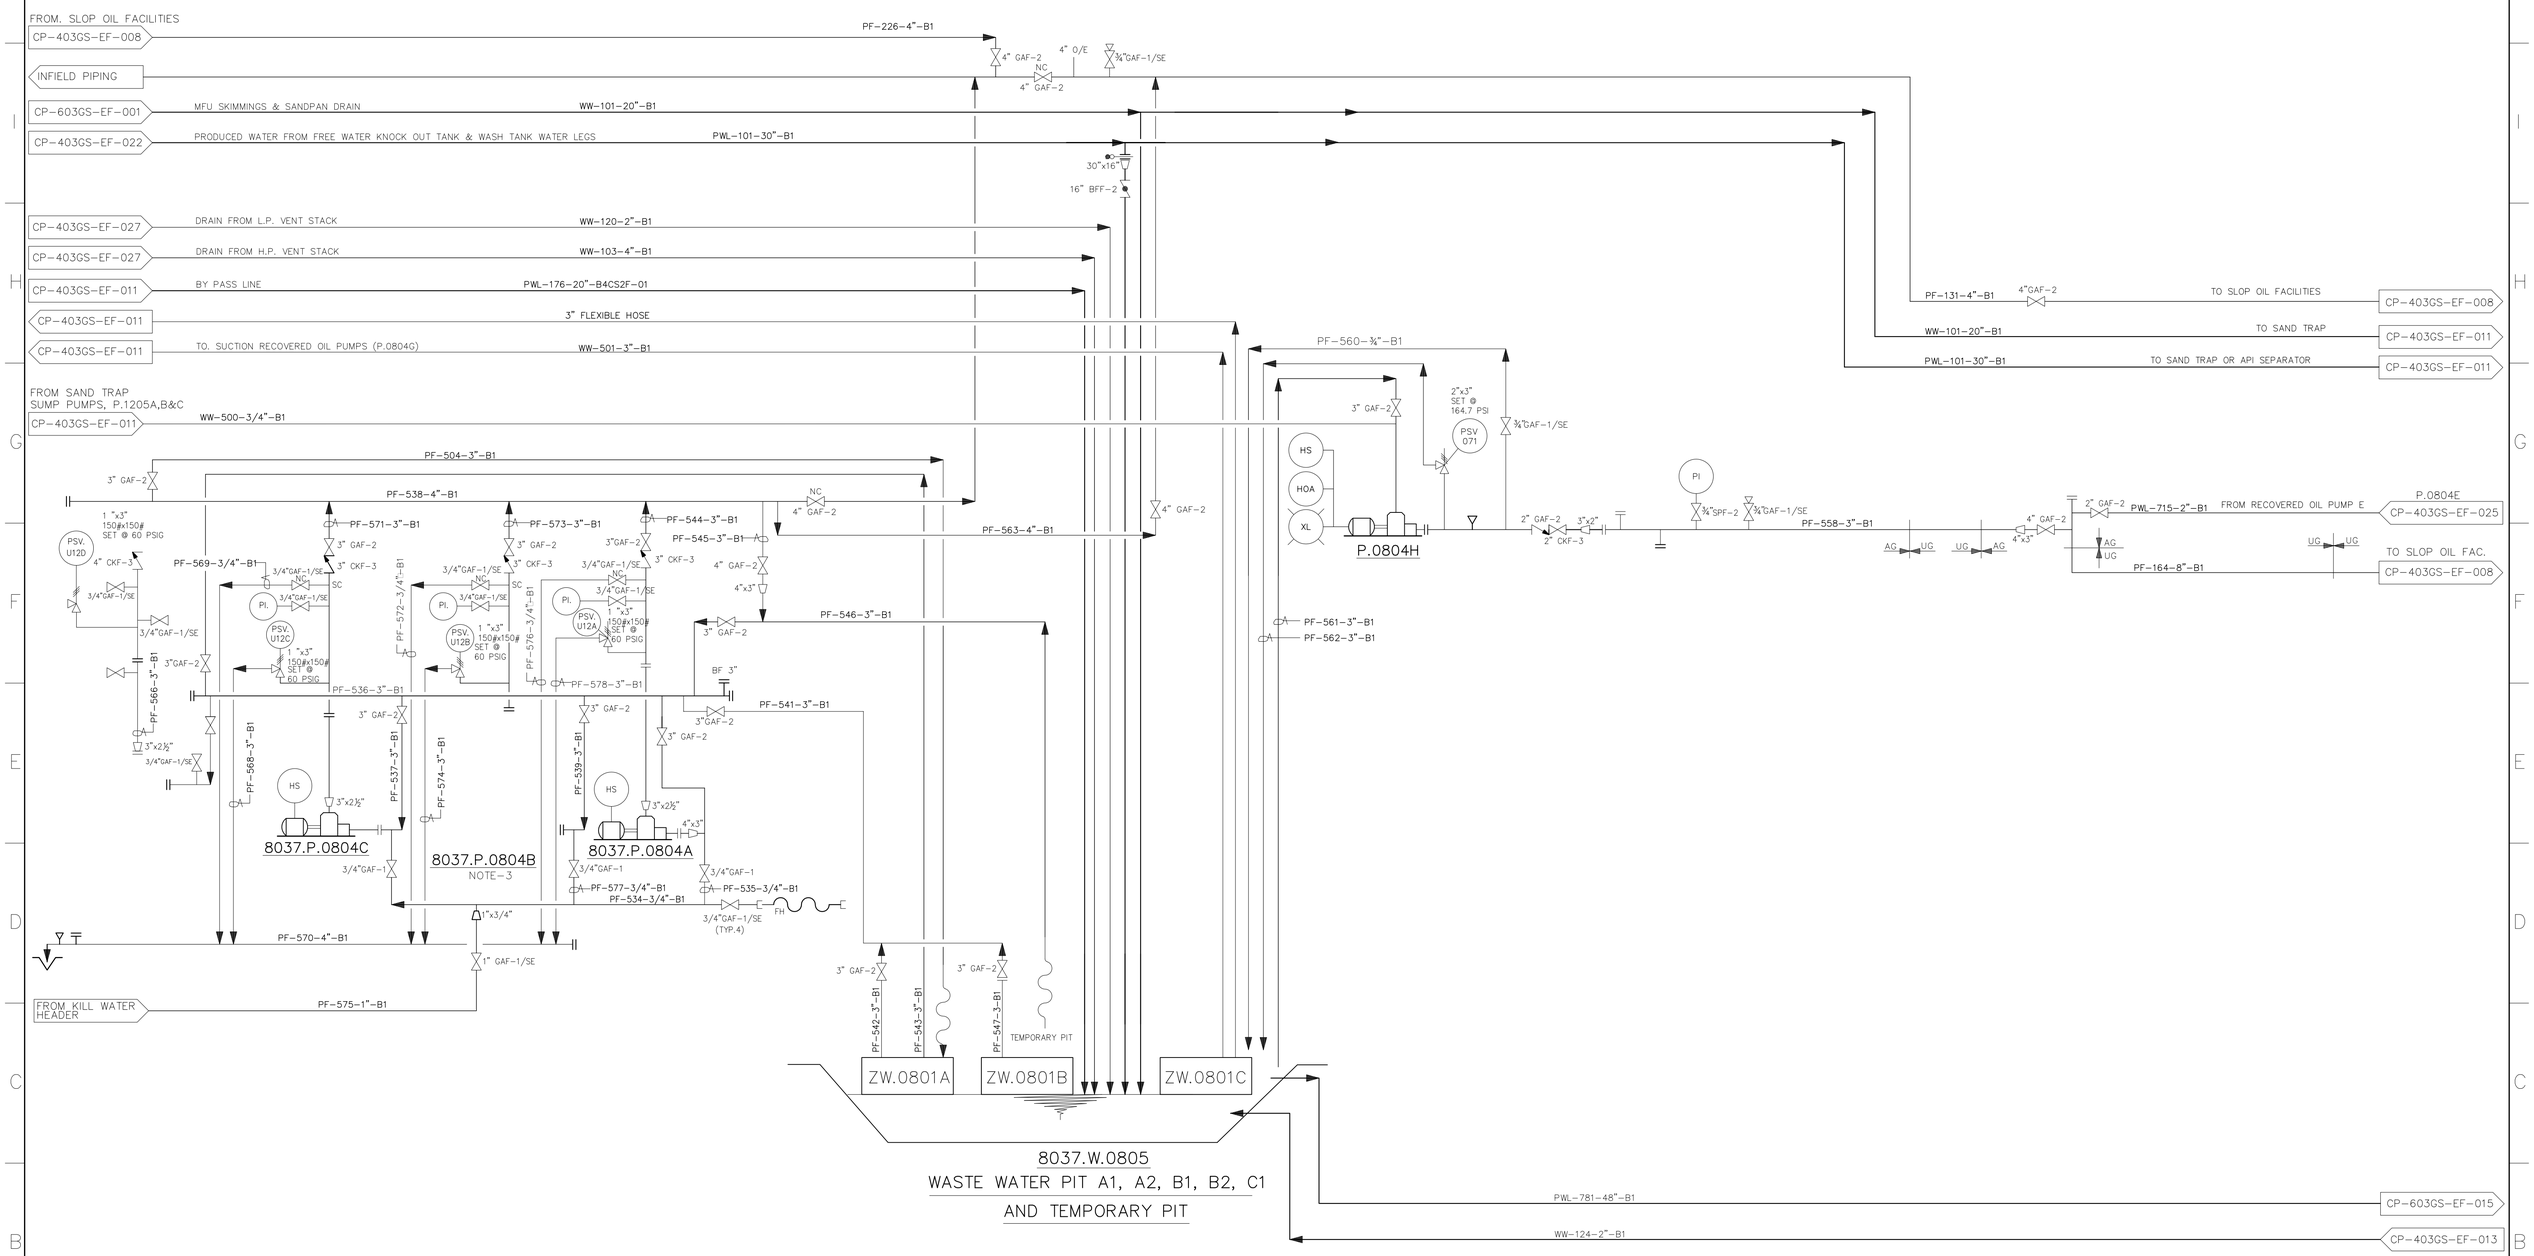

DRAWING NO.	TITLE
ICM-GB-J15127(A~G&J)	PID STANDARD LEGENDS
CP-403GS-EF-001	P&ID OIL TREATING FACILITIES (SHT.-1)
CP-403GS-EF-005	P&ID OIL TREATING FACILITIES LACT UNIT
CP-603GS-EF-007	P&ID WATER TREATING FACILITIES SLOP TREATMENT
CP-403GS-EF-006	P&ID OIL TREATING FACILITIES SLC STORAGE
CP-403GS-EF-086	PIPING AND INSTRUMENT DIAGRAM INSTALLATION 4" CONTROL VALVE SHIPPING PUMPS 8037-EM-0803A,B,C,D,E

REFERENCE DRAWINGS

NO	DATE	BY	DRAFT CHKD	ENGR CHKD	PSI COOR	
0	14-09-20	FZ	SD	PUTM	TXPA	AS BUILT NEW DRAWING AS PER PSI V&V (PID IMPROVEMENT) MOC # 307724

REVISION

PERTAMINA HULU ROKAN

PROJECT NO.	DRAWN:	ENGR:	DEPT:	DATE:
21/OE-PMF/RP/2011	FZ	TXPA	PSM	09-SEP-2020

PIPING & INSTRUMENT DIAGRAM
OIL TREATING FACILITIES
RECOVERED OIL PUMPS & WASTE WATER PITS
CENTRAL GATHERING STATION DURI AREA-3

DURI-OTPF03GS000-PRO-PID-IBU-0122-00

SIZE: A1 | SCALE: NTS | REV: 0 | SHEET: 1 OF 1