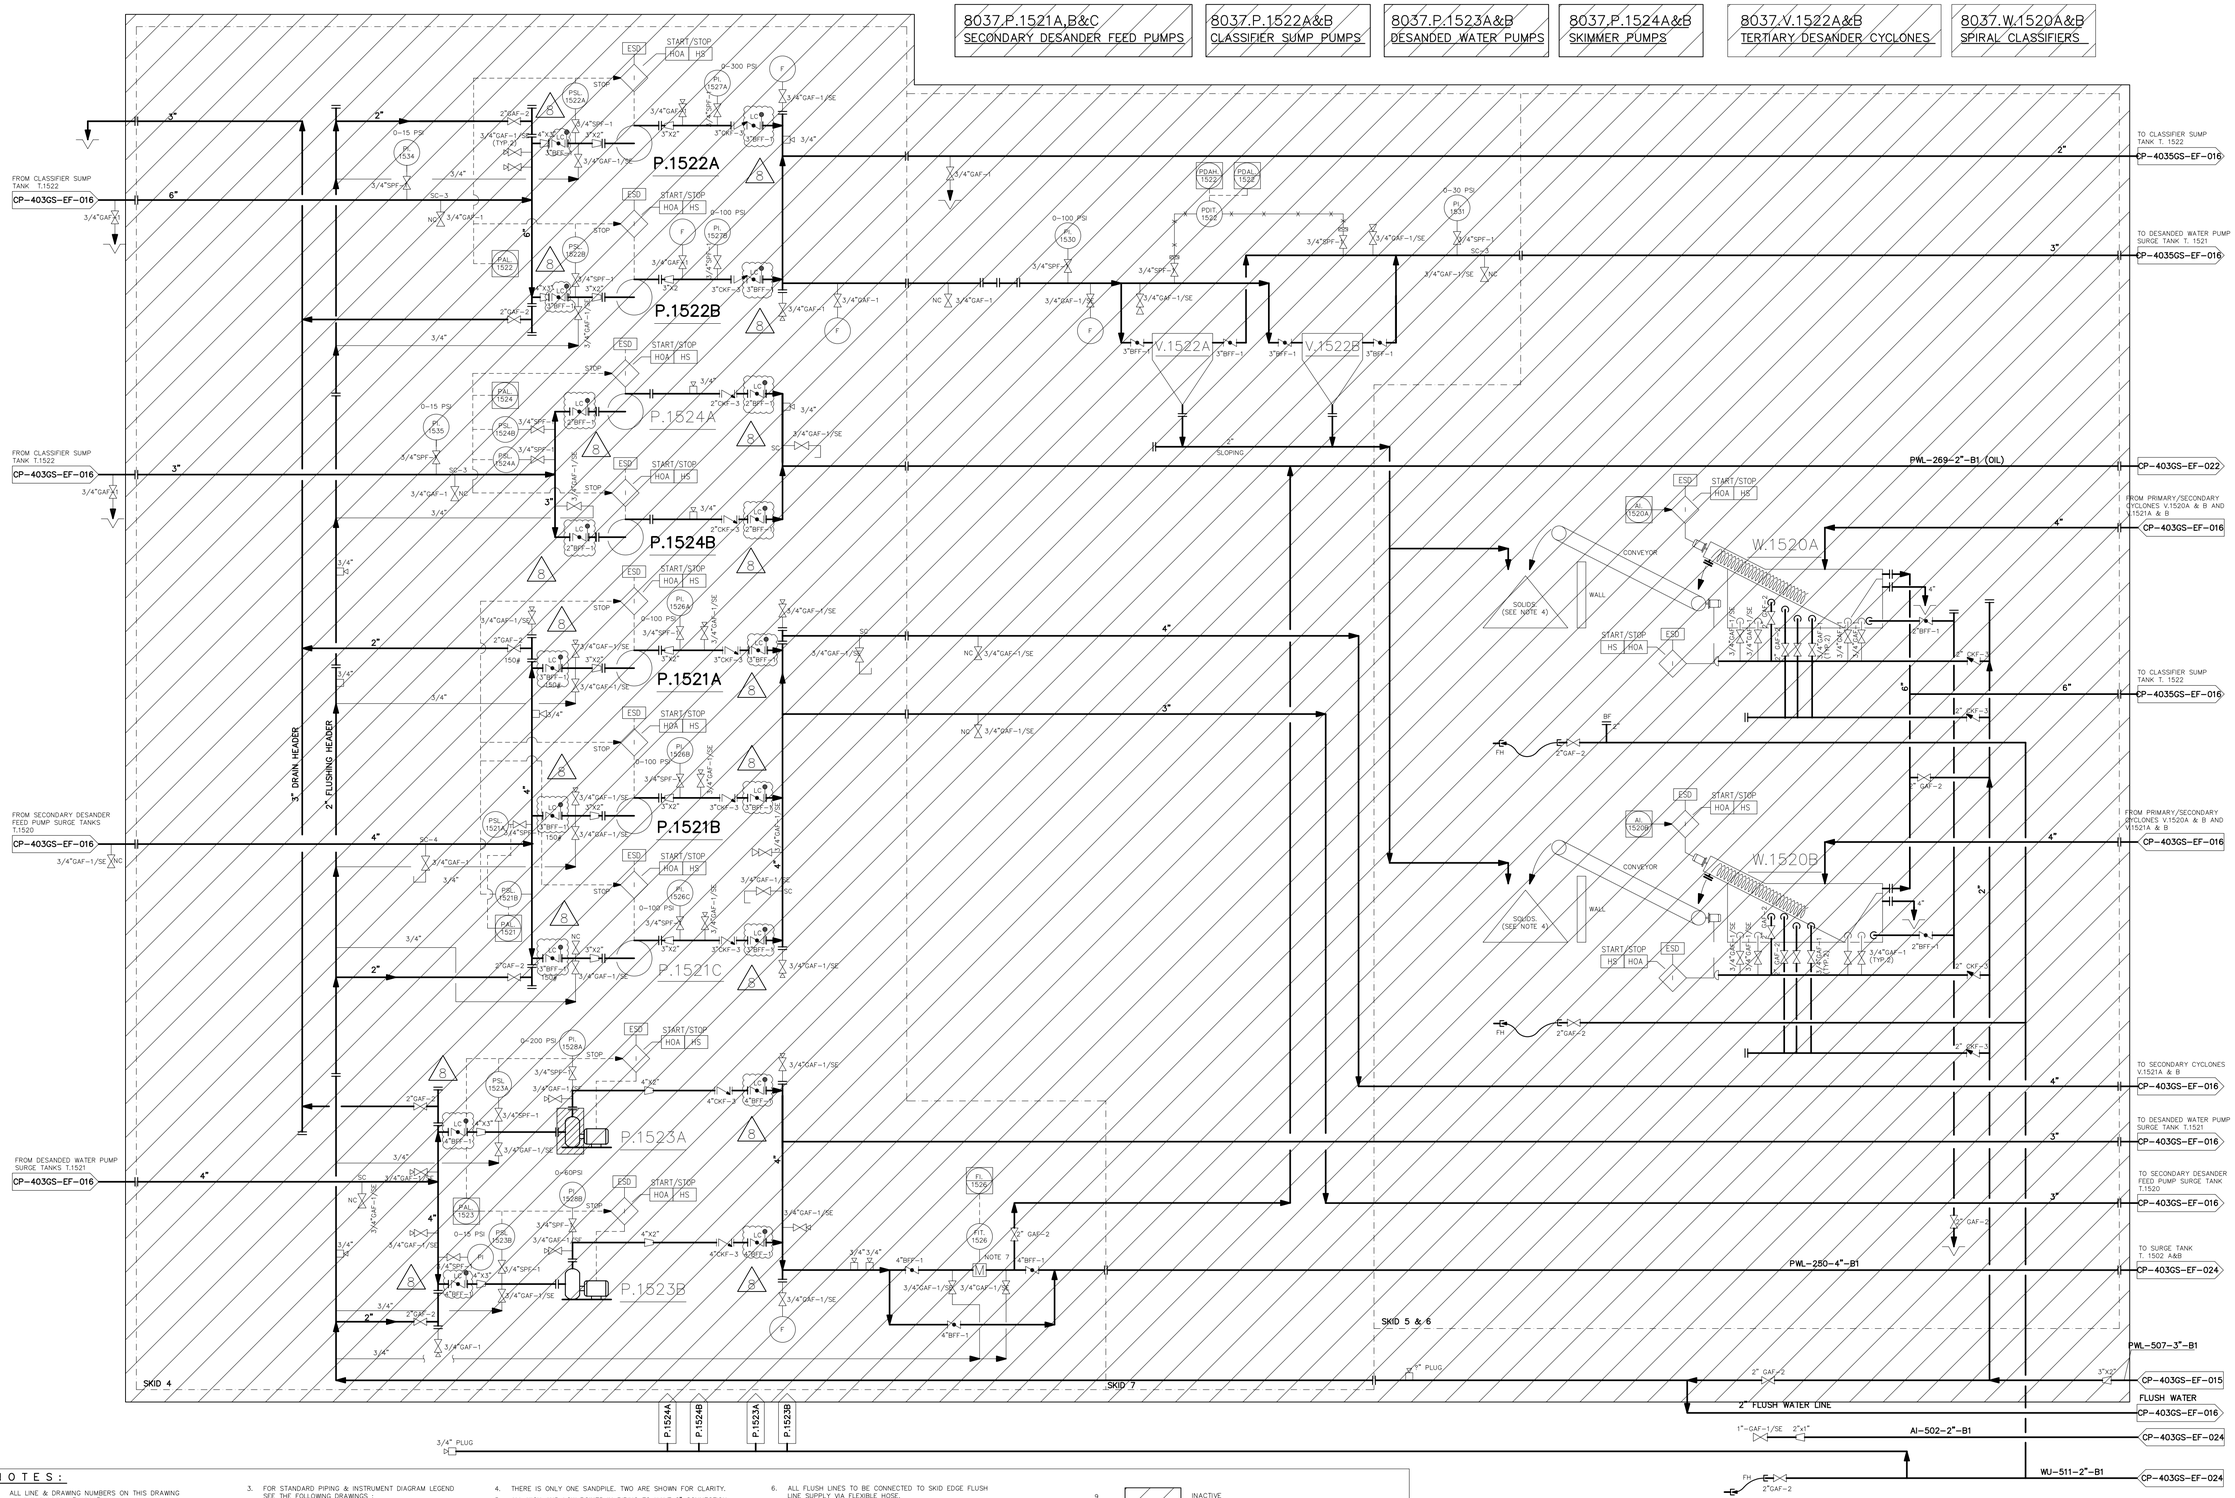

NOTES:

1. ALL LINE & DRAWING NUMBERS ON THIS DRAWING HAVE THE PREFIX "403GS".
2. ALL EQUIPMENT & INSTRUMENT NUMBERS ON THIS DRAWING HAVE THE PREFIX "8037". UNLESS OTHERWISE NOTED.
3. FOR STANDARD PIPING & INSTRUMENT DIAGRAM LEGEND SEE THE FOLLOWING DRAWINGS :
   - FOR PIPING & EQUIPMENT : CP-050GN-EF-002
   - FOR INSTRUMENTATION : CP-050GN-EF-003
4. THERE IS ONLY ONE SANDPILE. TWO ARE SHOWN FOR CLARITY.
5. ALL HIGH AND LOW POINTS IN PIPING TO HAVE 1" CONNECTION WITH GATE VALVE AND HEX. PLUG FOR VENTS AND DRAINS.
6. ALL FLUSH LINES TO BE CONNECTED TO SKID EDGE FLUSH LINE SUPPLY VIA FLEXIBLE HOSE.
7. FLOW METER TO BE 4" KROHNE-CAPAFLUX COMPACT MAGNETIC FLOW METER 2 F.W. 5080-K-CAP
8. DELETED
9. INACTIVE
10. ALL OF INSTRUMENTATION IS INACTIVE BASED MOC #814706

DURI-OTPF03GS000-PRO-PID-IBU-0117-00

REV.	DATE	DESCRIPTION	BY	CHKD	DESIGN ENG'R	DESIGN T. LDR	PROJ ENG'R	PSI COOR
8	28-07-21	(UPDATED AS PER MOC #814706 (BLANKED MOC-INACTIVE EQUIPMENT IN POD)	RPGN	PUTM	–	–	NNHP	TXPA
7	17-06-21	(UPDATED AS PER MOC #814706 (BLANKED MOC-INACTIVE EQUIPMENT IN POD)	RPGN	PUTM	–	–	NNHP	TXPA
6	26-12-18	AS BUILT (PSI V&V AS PER MOC#481540)	SM	AM	–	–	TZSX	
5	01-08-17	UPDATED AS PER FIELD VERIFICATION MOC#307724	ILH	TZSX	–	–	TZSX	
4	02-03-17	AS-BUILT PSI V&V BY PSM-PSI REMEDIATION PROJECT UNDER JOB NO.2445.	ND	ADR	RQS	MWS	RQS	
3	16-12-15	AS BUILT PSM-PSI REMEDIATION PROJECT UNDER JOB NO.2445	HP	JX	BAY	MWS	BAY	
2	03-11-11	AS BUILT DONE BY TF JAKARTA	ARN	DKM	IKS	JA	AKH	

REFERENCE DRAWINGS

P&ID SLURRY TANKS AND PUMPS, SURGE TANK AND WASH TANK	CP-405GS-EF-016
P&ID SAND PLANT SKIDS 1,2 & 3	CP-405GS-EF-017

PERTAMINA HULU ROKAN

DRAWN	S.GANDA	21-07-99
CHECKED	JT	21-02-07
DESIGN ENG'R.	WM	21-02-07
DESIGN TEAM LEADER	DMJ	21-02-07
PROJECT ENG'R.	WM	21-02-07
OPR'G DEPT.	ZSA	21-02-07

DRAWING TITLE

PIPING & INSTRUMENT DIAGRAM SAND PLANT SKIDS 4,5,6 & 7 CENTRAL GATHERING STATION DURI AREA-3

ITC NO. 21/OE-PMF/RIP/2011 21/OE-PMF/2011

SCALE : N.T.S

SIZE :

CAD

DRAWN WITH CAD NEVER CHANGE THIS DRAWING BY HAND

DRAWING NO.

CP-403GS-EF-017-8