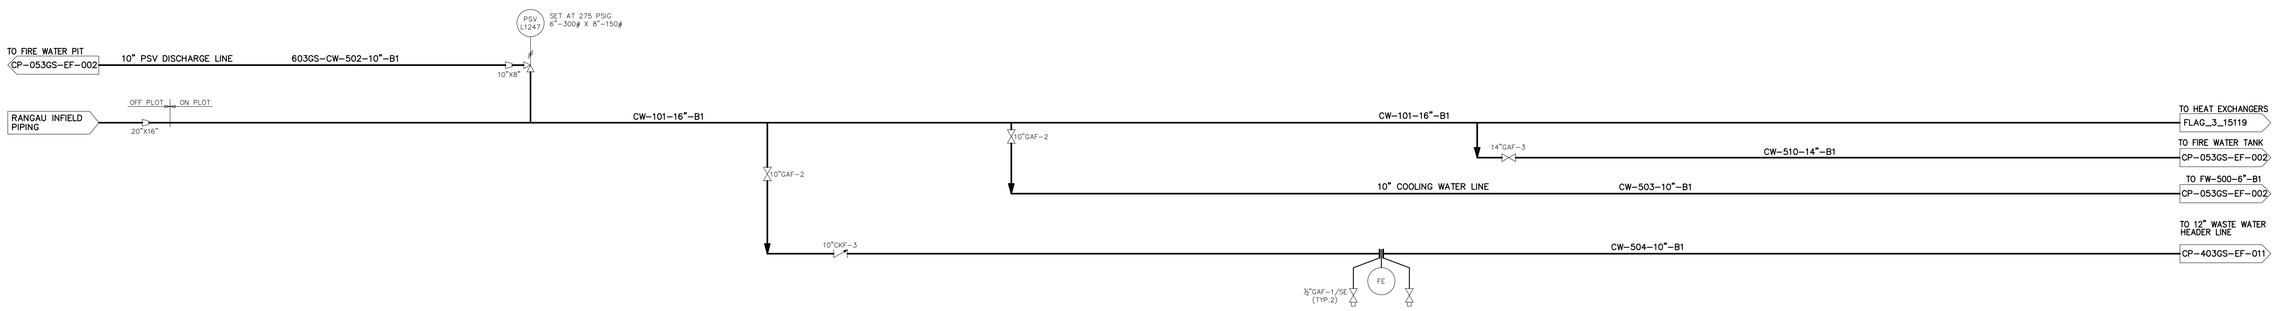

NOTES :

1. ALL EQUIPMENT, INSTRUMENT AND LINE NUMBERS ON THIS DRAWING HAVE THE PREFIX "8037" UNLESS OTHERWISE NOTED.
2. THE LETTERS "I" & "O" ARE NOT USED IN THE EQUIPMENT NUMBERING SYSTEM.
3. FOR STANDARD PIPING & INSTR. DIAGRAM LEGEND SEE THE FOLLOWING DRAWINGS :
   - FOR PIPING & EQUIPMENT : DWG. NO. CP-050GN-EF-002
   - FOR INSTRUMENTATION : DWG. NO. CP-050GN-EF-003

DURI-WTPF03GS000-PRO-PID-IBU-0058-00

REV.	DATE	DESCRIPTION	BY	CHKD	DESIGN ENG'R	DESIGN T. LDR	PROJ ENG'R	OPR'G DEPT.
8	26-12-18	AS BUILT (PSI V&V AS PER MOC #481540)	SM	AM			TZSX	
7	16-12-15	AS BUILT PSM-PSI REMEDIATION PROJECT UNDER JOB NO.2445	HP	JX	BAY	MWS	BAY	
6	23-07-15	UP-DATE FOR SMO FLARE & RELIEF PROJECT (JOB NO.#2332)	RDY	EVK	MRD	MWS	MRD	
5	03-11-11	AS BUILT DONE BY TF JAKARTA	ARN	DKM	IKS	JA	AKH	
4A	30-09-11	AS BUILT DONE BY TF JAKARTA (ISSUED FOR APPROVAL)	AP	DKM	IKS	JA	AKH	
3	28-01-10	AS BUILT BACKWASH & KILLWATER PUMP DISMANTLE (#4558)	RUJI	ADR	HHW	TIH	HHW	
C	26-11-98	GENERAL REVISIONS (AS-BUILT)	SUR	—	—	—	—	

REFERENCE DRAWINGS

PERTAMINA HULU ROKAN

THIS DOCUMENT IS UNCONTROLLED WHEN PRINTED, VERIFY THE LATEST VERSION AT THE PSI SHAREPOINT OR DOCUMENTUM PINTAR. ANY OR ALL MODIFICATIONS TO THIS DOCUMENT SHALL FOLLOW APPROVED MOC OR DOCUMENT MANAGEMENT PROCESSES. COPYRIGHT PERTAMINA HULU ROKAN.

DRAWN	ADR	12 August 92
CHECKED	JAS	07-10-92
DESIGN ENG'R.	IWA	02-09-92
DESIGN TEAM LEADER		
PROJECT ENG'R.	BDG	07-10-92
OPR'G DEPT.		

DRAWING TITLE

PIPING AND INSTRUMENT DIAGRAM
KILLWATER FILTERS
WATER TREATING FACILITIES
DURI AREA-3

ITC NO. 21/OE-PMF/RP/2011 21/OE-PMF/2011

SCALE : NTS

SIZE :

CAD
DRAWN WITH CAD NEVER CHANGE THIS DRAWING BY HAND

DRAWING NO.

CP-603GS-EF-013-8