8037.T.0811 B & C NOTE-8

SOP FWKO TANK (1500 BBL)

DIMENSIONS : 21'-6" DIA. X 24'-0" H.
TRIM : TE-T-11 A-B1

8037.V.0803A & B

FOULED GAS BOOTS

DIM. : 36" O.D. X 40'-0" H

8037.T.0812 C & D

SOP WASH TANKS (1000 BBL)

DIMENSIONS : 21'-6" DIA. X 16'-0" H.
TRIM : TE-T-12 C & D
DESIGN PRESSURE : 3 IN H20/2 IN H20
MAX. OPERATING TEMP. : 200°F

NOTE

1. ALL EQUIPMENT AND INSTRUMENT NUMBERS ON THIS DRAWING HAVE THE PREFIX 8037 UNLESS OTHERWISE NOTED.
2. THE LETERS "I" & "O" ARE NOT USED IN THE EQUIPMENT NUMBERING SYSTEM
3. DELETED
4. DELETED
5. DELETED
6. DELETE
7. DELETE
8. TANK T.0811C AT FIELD CONDITION ARE T.0816
9. SAMPLE COCK : 8 PCS (2', 4', 6', 8', 10', 12', 14', 16")
10. SAMPLE COCK : 5 PCS (6', 8', 10', 12', 14')

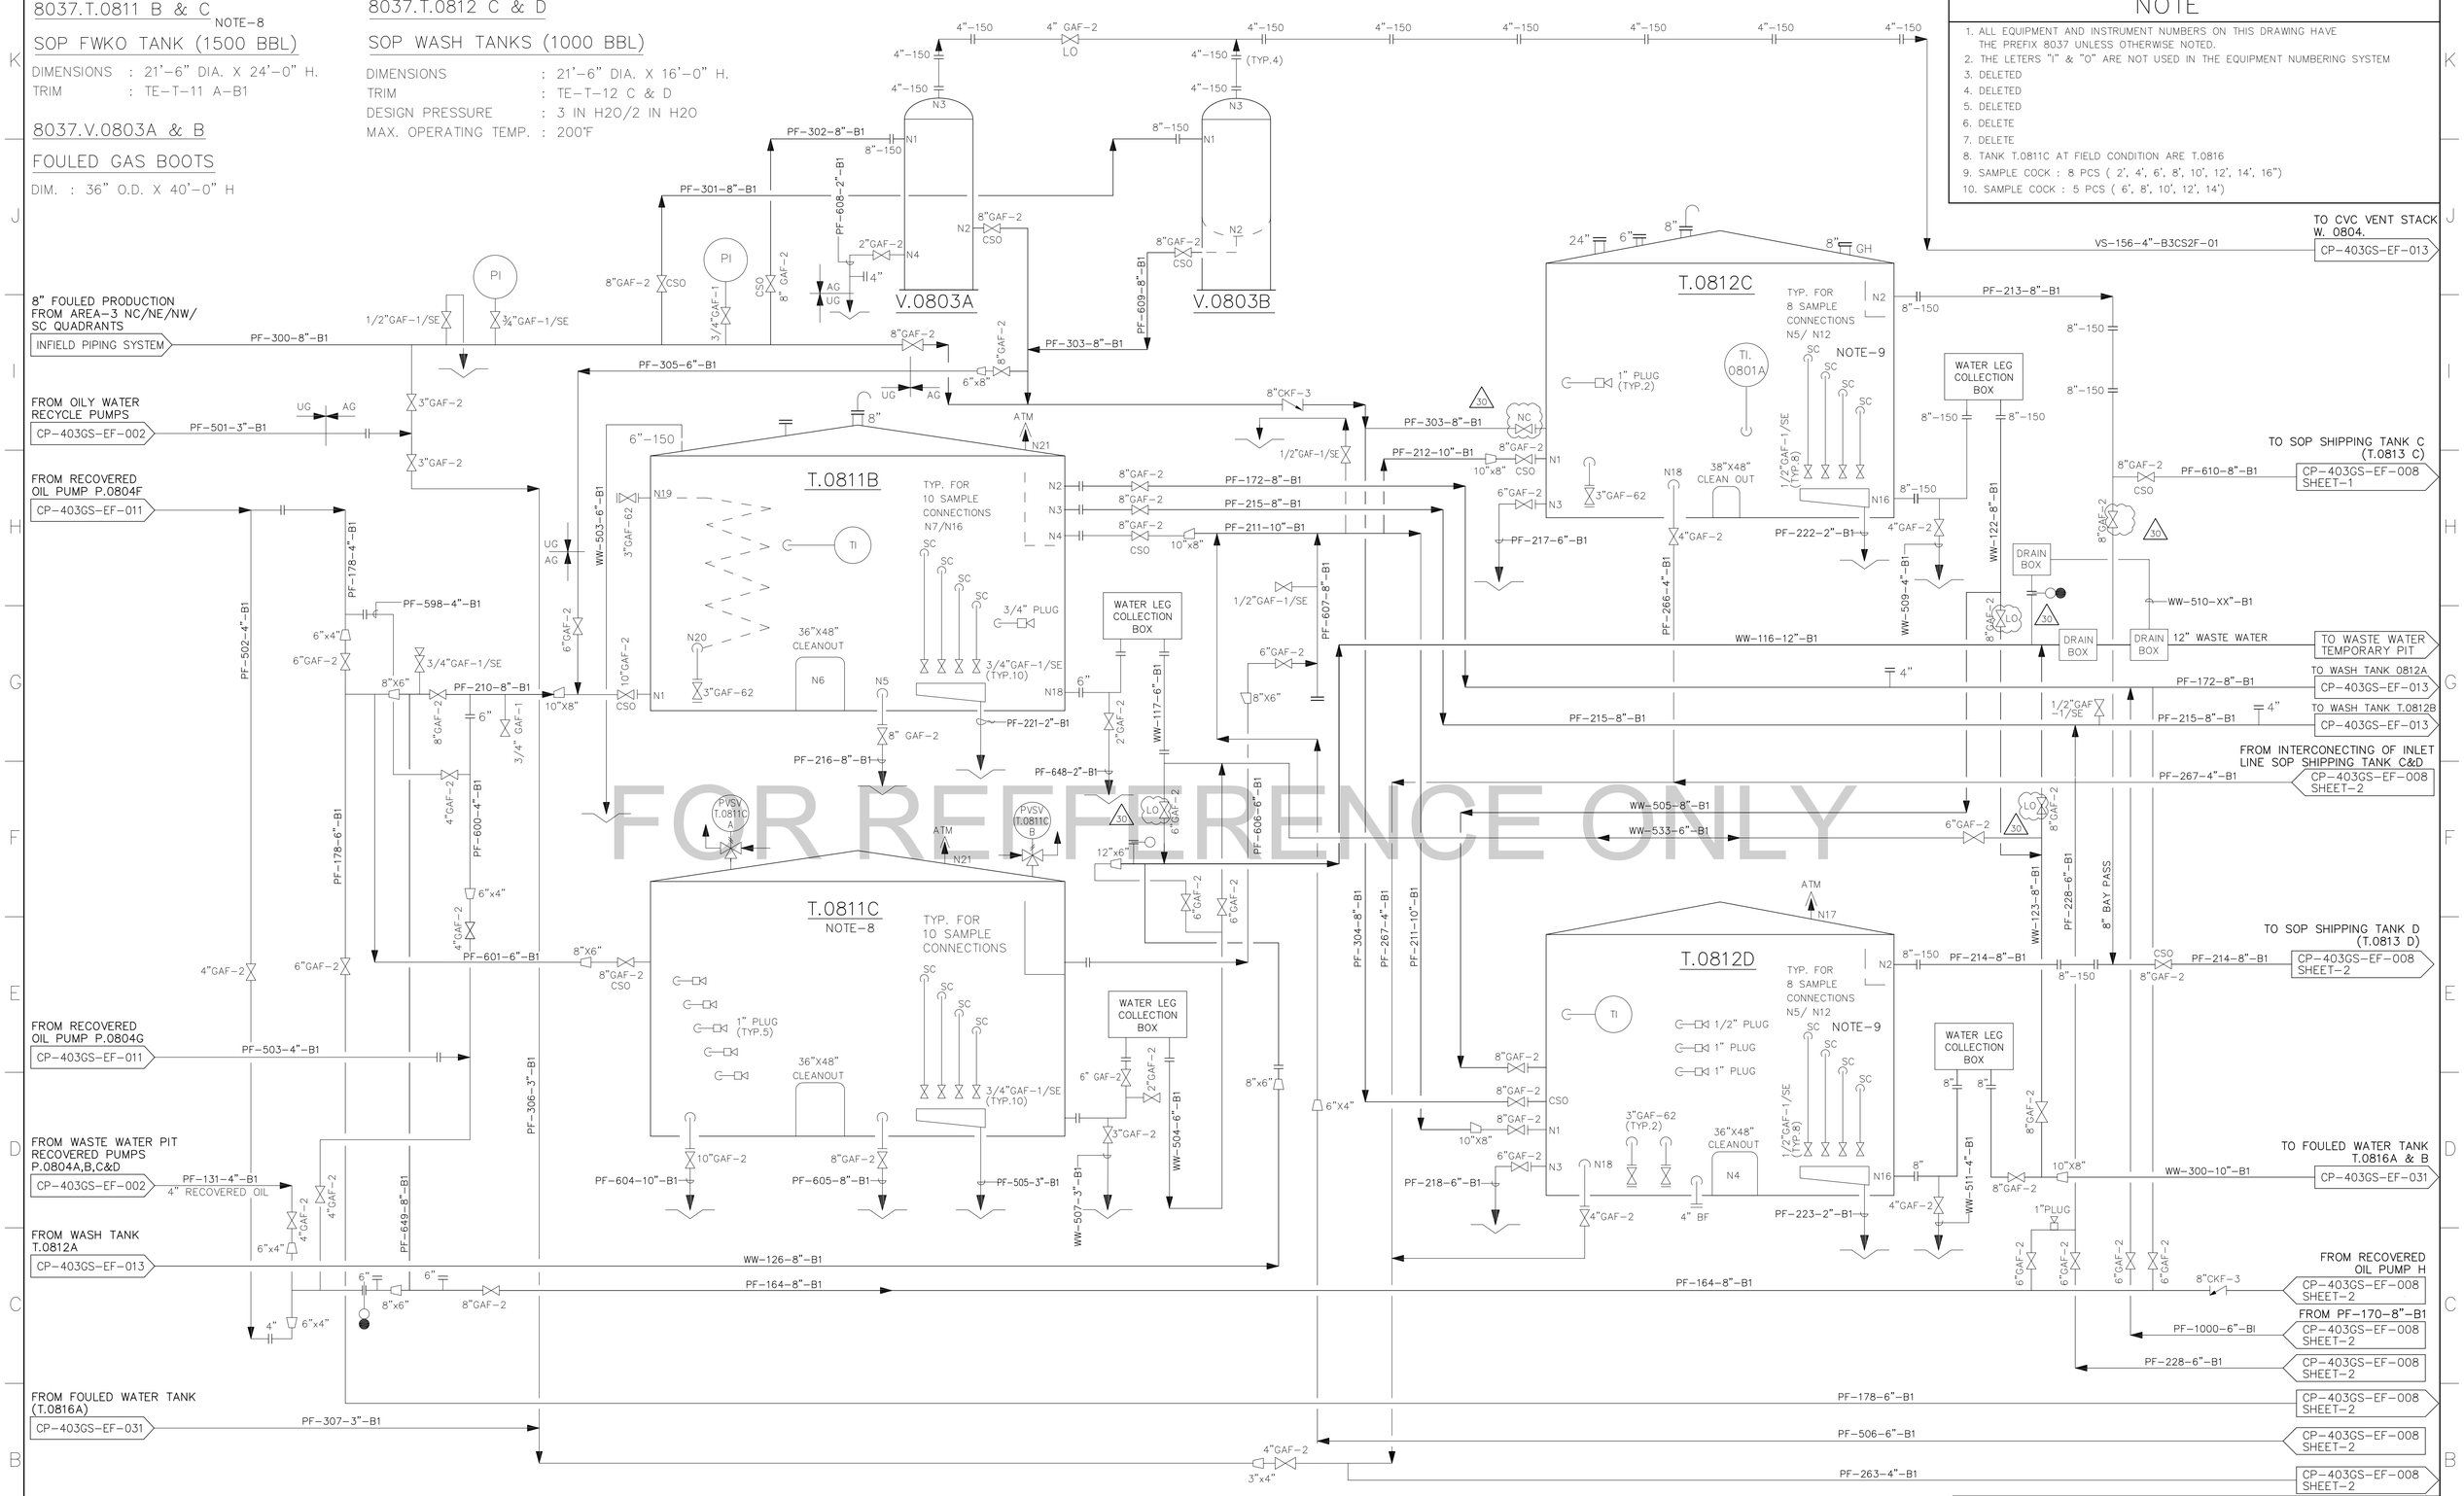

FOR REFERENCE ONLY

DRAWING NO.	TITLE
ICM-GB-J15127(A~G&J)	PID STANDARD LEGENDS
DURI-OTPF03GS000-PRO-PID-IBU-0077-01	P&ID-SLOP OIL TREATING FACILITIES FOULED GAS BOOTS, SOP(FWKO& WASH TANKS) CGS-3
CP-403GS-EF-013	P & ID - CVC TREAT. FAC
CP-403GS-PP-039	PIPING PLAN FOUL WATER SYSTEM
CP-403GS-PP-023	PIPING PLAN CVC SLOP OIL TREAT. FACILITIES
CP-403GS-PP-024	PIPING PLAN CVC SLOP OIL TREAT. FACILITIES

REFERENCE DRAWINGS

NO	DATE	BY	DRAFT CHKD	ENGR CHKD	PSI COOR	
30	03-03-23	RKP	NOV	NOV	TXPA	AS BUILT MOC#5366-BLANKED PROSES REVALIDASI VAC DI FASILITAS POD
29	18-08-20	FZ	SD	PUTM	TXPA	UPDATE AS PER PSI V&V (PID IMPROVEMENT) MOC # 307724
28	03-08-20	RPGN	PUTM	–	TXPA	UPDATED AS PER PSI V&V (ID#5989)
27	20-07-20	RIO	YAN	APS	GPH	AS-BUILT DRAWING MOC.571566
26	25-07-19	RPGN	PUTM	–	AOZL	UPDATED AS PER PSI V&V MOC#307724
25	16-04-19	MDC	CHM	SYAF	SAW	AS-BUILT FOR MOC 421596

REVISION

PERTAMINA HULU ROKAN

PROJECT NO.	DRAWN:	ENGR:	DEPT:	DATE:
21/OE-PMF/RP/2011	FZ	TXPA	PSM	20-JULY-2020

DURI-OTPF03GS000-PRO-PID-IBU-0077-00

PIPING & INSTRUMENT DIAGRAM
SLOP OIL TREATING FACILITIES
FOULED GAS BOOTS, SOP(FWKO &WASH TANKS)
CENTRAL GATHERING STATION DURI AREA-3

CP-403GS-EF-008-30

SIZE: A1 | SCALE: NTS | REV: 30 | SHEET: 1 OF 2